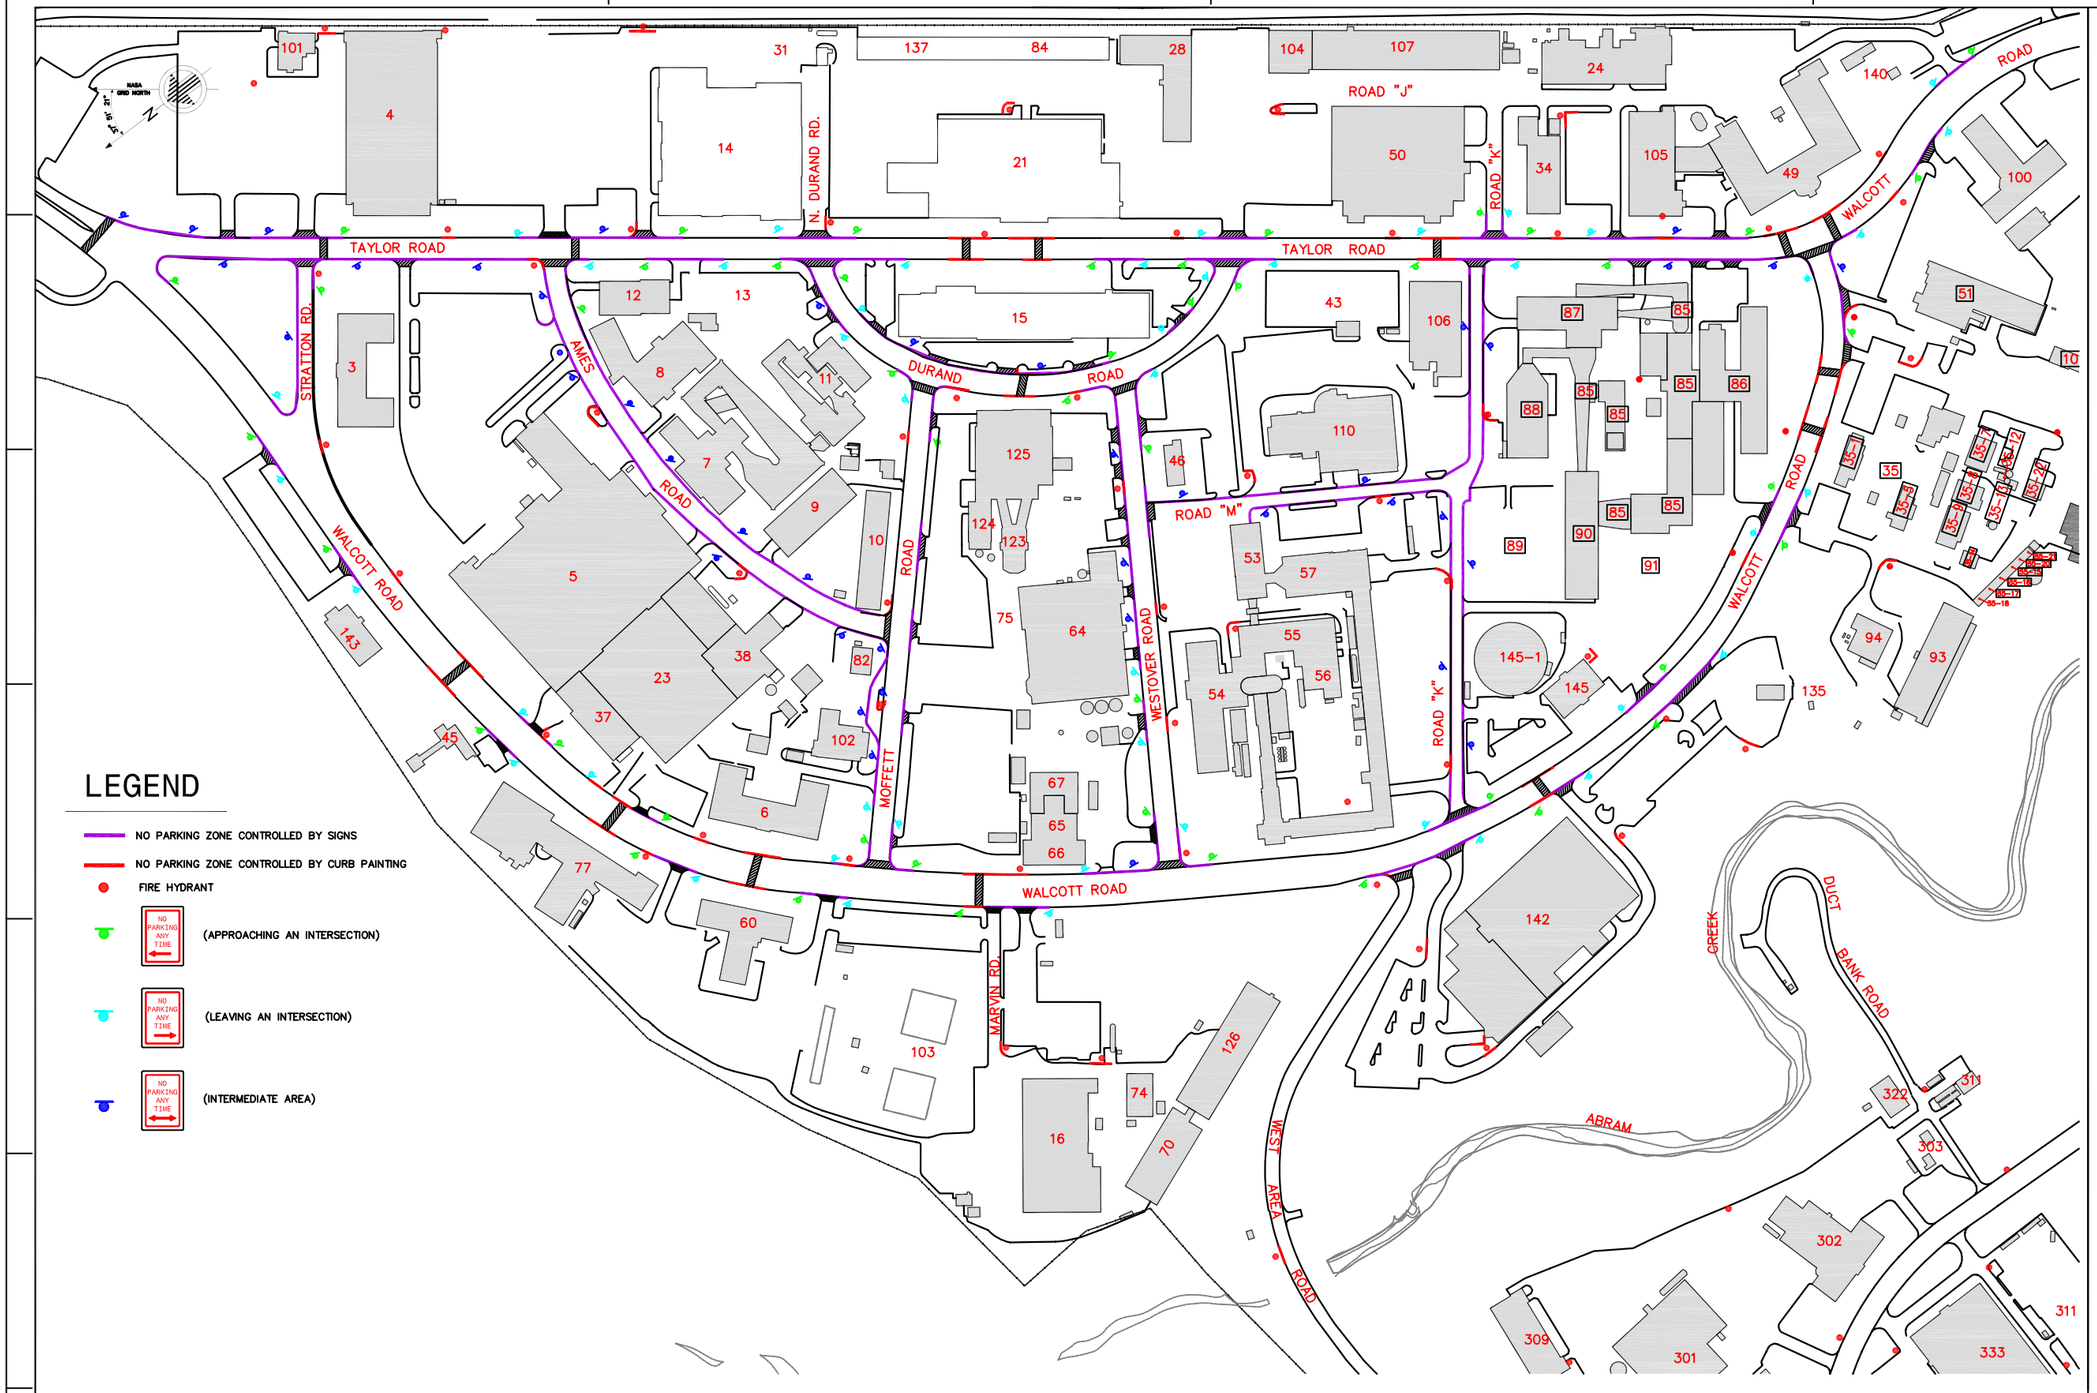

AUTOCAD DRAWING
DO NOT REVISE MANUALLY

CHG	ZONE	DESCRIPTION	APP/DATE

REVISIONS

DESIGN CONTRACTOR

FACILITIES DIVISION

GLENN RESEARCH CENTER

DR. TD	DES.	D.ENG. TD
PROJ. MGR. TD	F. BR. CH. RDP	F. DIV. CH.
FAC./SYS. MGR. RDP	E. BR. CH.	E. DIV. CH.
R. ENG.	R. BR. CH.	R. DIV. CH.

DRAWN | CHECKED | DESIGNED
APPROVED | DATE

NATIONAL AERONAUTICS AND SPACE ADMINISTRATION
JOHN H. GLENN RESEARCH CENTER
CLEVELAND, OHIO
LEWIS FIELD

NO PARKING ZONES

AS-BUILT DRAWING

SIZE	DRAWING NUMBER	REV	BLDG	AREA
CF		1		GRC

UNITS: METRIC

SCALE	OFFICIAL DATE	SHEET	DISCIPLINE
NTS	8-16-2006	1 OF 1	CIVIL

AUTOCAD 2006

REV | DRAWING NUMBER | SIZE CF